


**NORTH ELEVATION**

SCALE 1/4" = 1'-0"

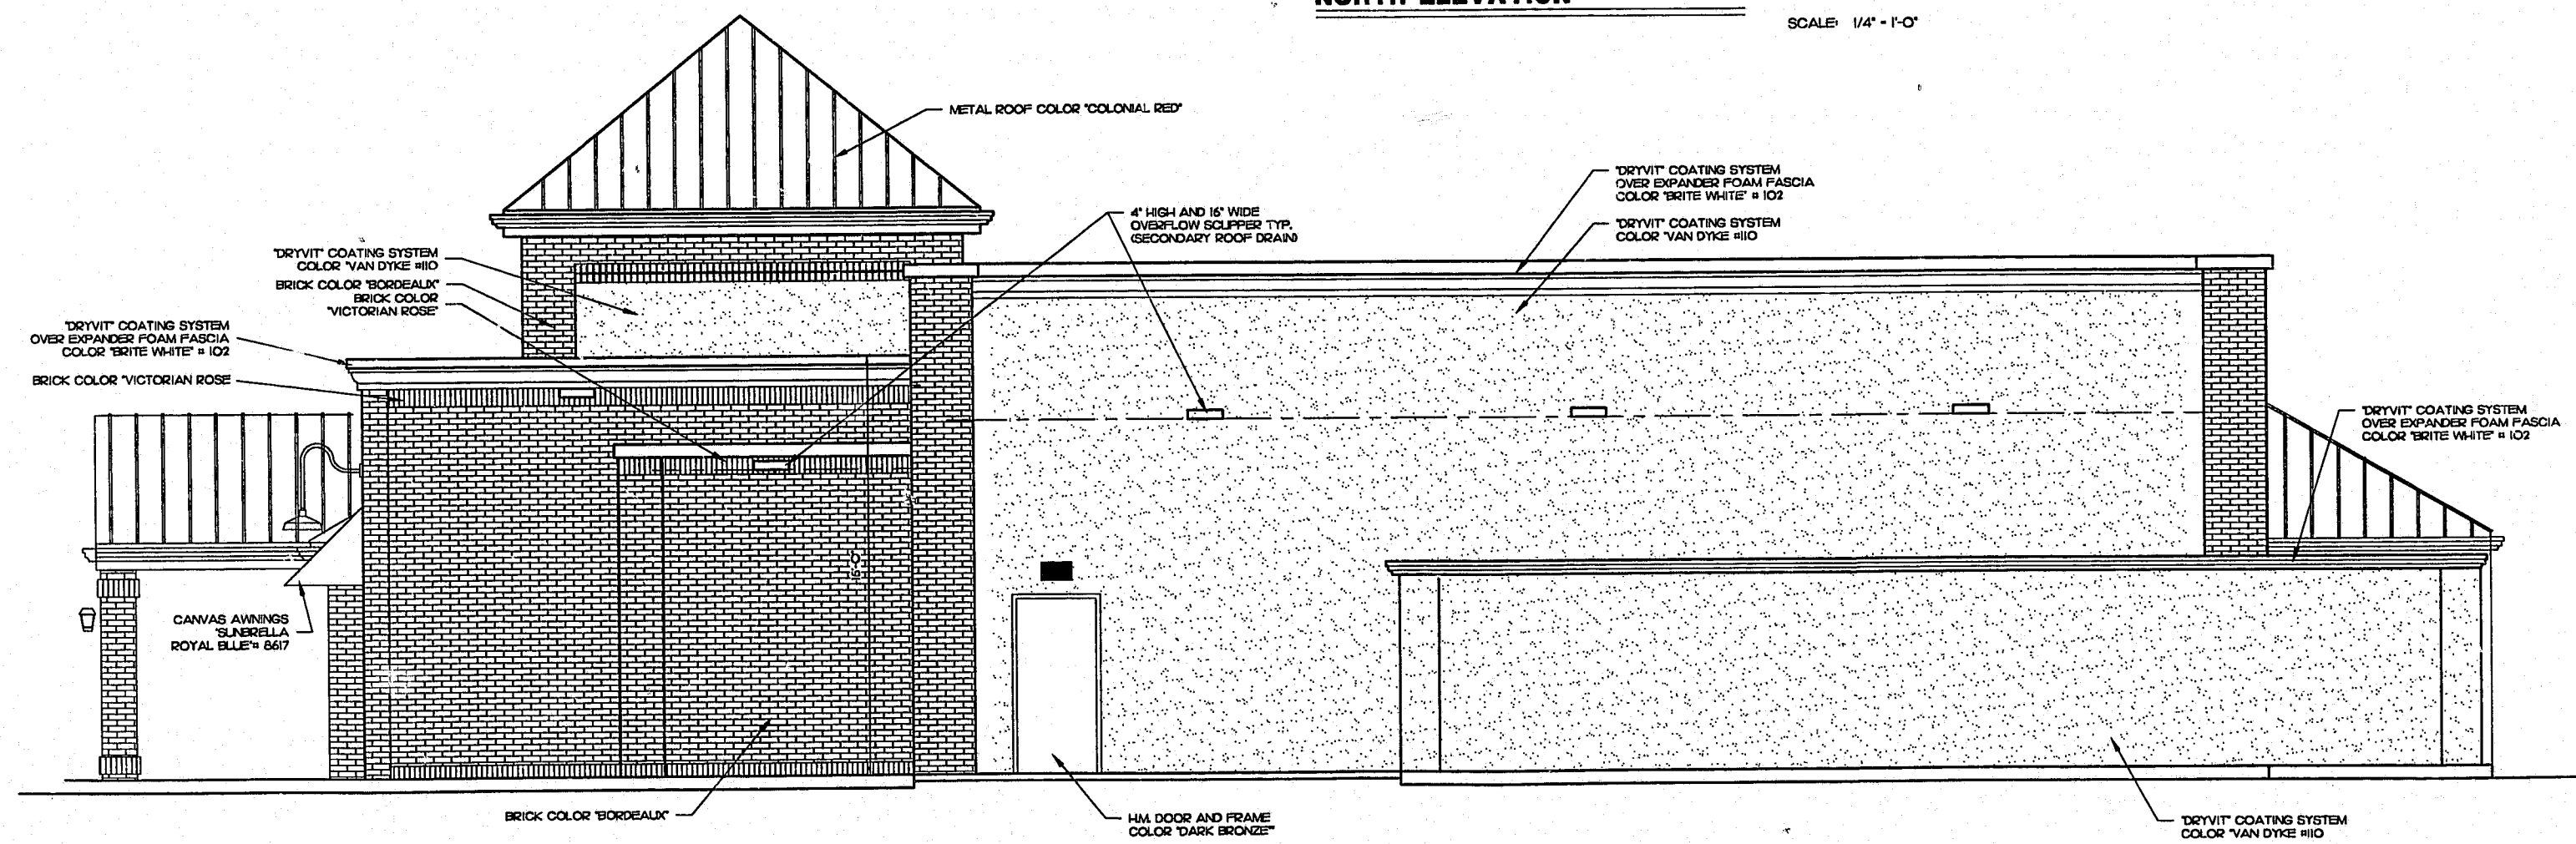


**SOUTH ELEVATION**

SCALE 1/4" = 1'-0"

01-SP-053  
**AS BUILT**  
 Smp  
 2.21.02

Date	No.	Revision	By
<b>ELEVATIONS</b>			
Project <b>CARY ALE HOUSE</b>			
Location <b>CENTRUM PLAZA CARY, N.C.</b>			
<b>MASTER PLAN INC.</b> JOHN DURANKO - ARCHITECT 214 SOUTHERN BOULEVARD WEST PALM BEACH, FL. 33411-2092			
Drawn by J.A.D.		Scale 1/4" = 1'	
Date 6/30/2001		File no. -	
SHEET NO <b>A-5.1</b>		of 3 shts.	

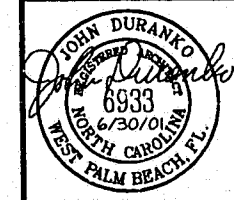

ALL DIMENSIONS MUST BE VERIFIED BY CONTRACTOR AND ARCHITECT MUST BE NOTIFIED OF ANY DISCREPANCIES BEFORE PROCEEDING WITH THE WORK.