

ASBUILT PLANS FOR
CARY PARK P.U.D.
 (FORMERLY KNOWN AS CARY GLEN P.U.D.)

PARCELS SF-7 and 8b

CARY, N.C.

CARY PROJECT # 00-SB-008



PROFESSIONAL ENGINEERS
 CERTIFICATION

PROJECT NAME & NUMBER: Cary Park PUD, Parcels SF-7 & SF-8 (00-SB-008)
 PERMIT NO.: WPO1010 DATE ISSUED: April 23, 2001

I, J. E. Rouse, as a duly registered Professional Engineer in the State of North Carolina, hereby certify that construction of these permitted facilities have been completed in accordance with the approved plans and specifications.

Signature: J. E. Rouse Date: 4/23/01

P. E. Registration No.: 16263




PROFESSIONAL ENGINEERS
 CERTIFICATION

PROJECT NAME & NUMBER: Cary Park PUD, Parcels SF-7 & SF-8 (00-SB-008)
 PERMIT NO.: WPO1010 DATE ISSUED: April 20, 2001

I, James E. Casfield, as a duly registered Professional Engineer in the State of North Carolina, hereby certify that construction of these permitted facilities have been completed in accordance with the approved plans and specifications.


Signature: James E. Casfield Date: 4/20/01

P. E. Registration No.: 16348

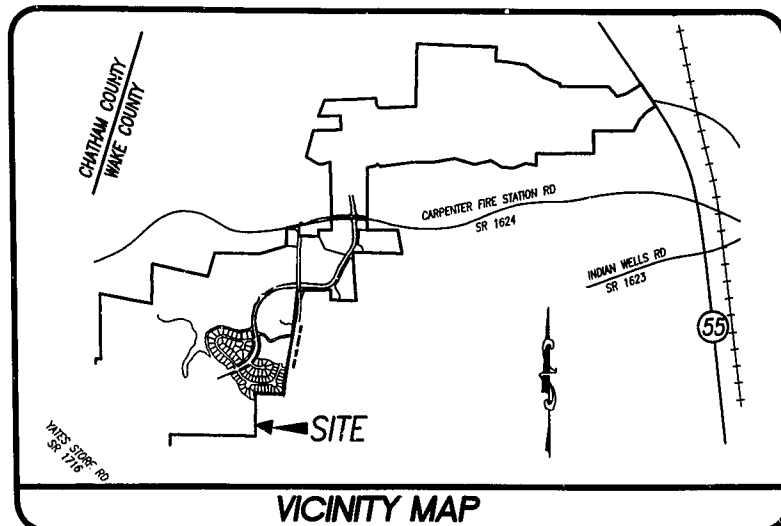

VICINITY MAP

INDEX OF SHEETS	
SITE PLAN	SHT 1
WATER, SANITARY SEWER, STORM DRAINAGE AND EROSION CONTROL	SHT 2
WATER, SANITARY SEWER, STORM DRAINAGE AND EROSION CONTROL	SHT 3
R001 PLAN & PROFILE	SHT 4
R002 PLAN & PROFILE	SHT 5
R003 AND R004 PLAN & PROFILE	SHT 6
R005 AND R006 PLAN & PROFILE	SHT 7
CARY GLEN BOULEVARD PLAN & PROFILE	SHT 8
SANITARY SEWER PROFILES	SHT 9
SANITARY SEWER PROFILES	SHT 10
UTILITY DETAILS	SHT 11
EROSION CONTROL AND STORM DRAINAGE DETAILS	SHT 12
ROADWAY DETAILS	SHT 13

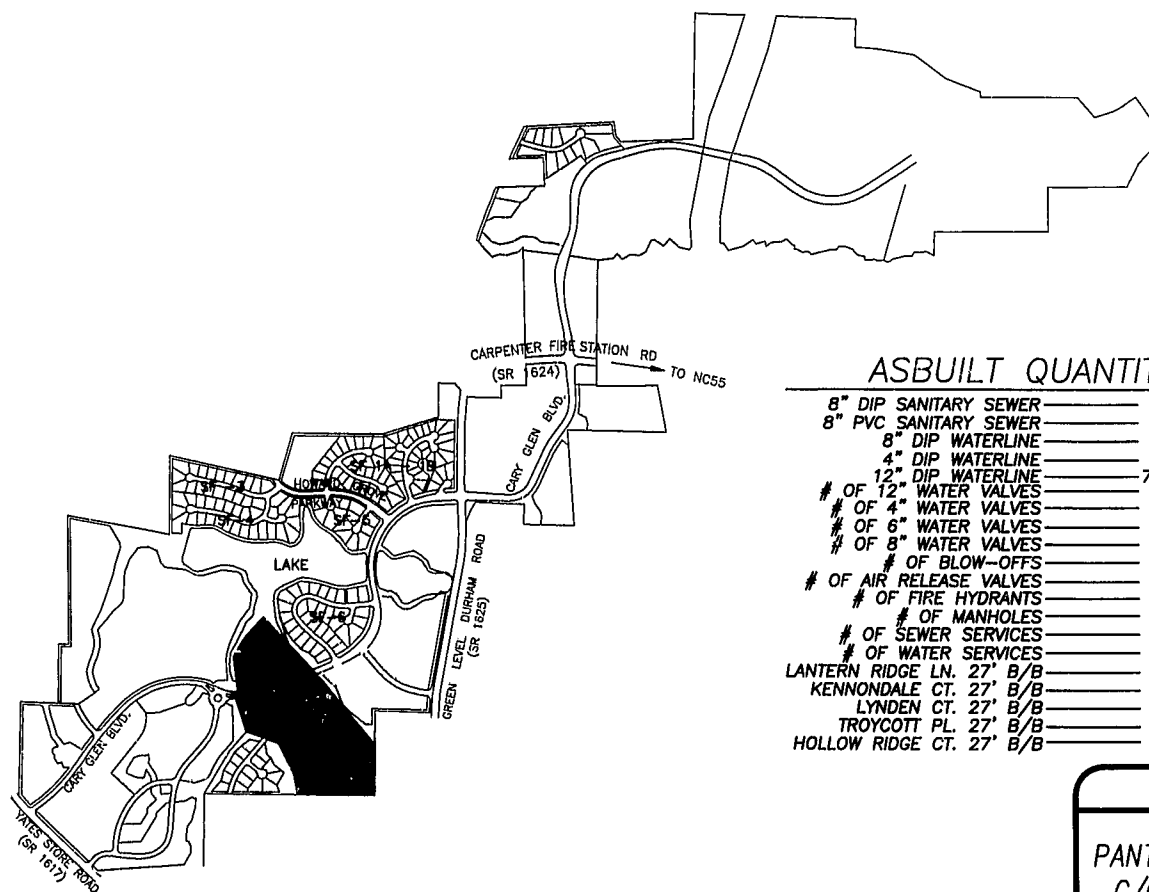

ASBUILT QUANTITIES

8" DIP SANITARY SEWER	641 LF
8" PVC SANITARY SEWER	3150 LF
8" DIP WATERLINE	1427 LF
4" DIP WATERLINE	1043 LF
12" DIP WATERLINE	708 LF
# OF 12" WATER VALVES	2
# OF 4" WATER VALVES	8
# OF 6" WATER VALVES	4
# OF 8" WATER VALVES	5
# OF BLOW-OFFS	5
# OF AIR RELEASE VALVES	3
# OF FIRE HYDRANTS	4
# OF MANHOLES	18
# OF SEWER SERVICES	55
# OF WATER SERVICES	51
LANTERN RIDGE LN. 27" B/B	1460 LF
KENNONDALE CT. 27" B/B	190 LF
LYNDEN CT. 27" B/B	210 LF
TROYCOTT PL. 27" B/B	310 LF
HOLLOW RIDGE CT. 27" B/B	320 LF

NOTE: SITE NOT LOCATED WITHIN 2000 FEET OF A TIE TO NORTH CAROLINA GRID COORDINATE SYSTEM.

DESCRIPTION	EXISTING	PROPOSED
2' CONTOUR INTERVAL	_____	_____
10' CONTOUR INTERVAL	_____	_____
PROPERTY LINE	_____	_____
ROADWAY CENTERLINE	_____	_____
RIGHT OF WAY LIMITS	_____	_____
EASEMENT LINE	_____	_____
CURB & GUTTER	_____	_____
SANITARY SEWER FACILITIES	○	●
STORM SEWER FACILITIES	□	■
WATERLINE	×	+
FIRE HYDRANT ASSEMBLY	⊕	⊕
FENCING STRUCTURE	○	●
WOODSLINE	~~~~~	_____
WATERWAYS	~~~~~	_____
SILT FENCING	_____	***

OWNER

PANTHER CREEK - RALEIGH LIMITED PARTNERSHIP, LLC
 C/O EAST WEST PARTNERS MANAGEMENT COMPANY
 190 FINLEY GOLF COURSE ROAD
 CHAPEL HILL, N.C. 27716
 (919) 929-0660
 FAX (919) 967-0959

DEVELOPER

EAST WEST PARTNERS MANAGEMENT COMPANY
 190 FINLEY GOLF COURSE ROAD
 CHAPEL HILL, N.C. 27716
 (919) 929-0660
 FAX (919) 967-0959



PREPARED BY:

WITHERS & RAVENEL
 ENGINEERING & SURVEYING, INC.

111 MacKENAN DRIVE
 CARY, NORTH CAROLINA 27511
 TELEPHONE: OFFICE (919) 469-3340
 FAX No. (919) 467-6008



Landscape Architecture
 Land Planning
 Environmental Design

905 Jones Franklin Road
 Raleigh, North Carolina 27608
 (919) 851-7150 fax. (919) 851-7547

277 S.E. 5th Avenue
 Delray Beach, Florida 33483
 (561) 276-0453 fax. (561) 272-7583