


A003 (PRIVATE ALLEY SECTION, 20' PRIVATE R/W)

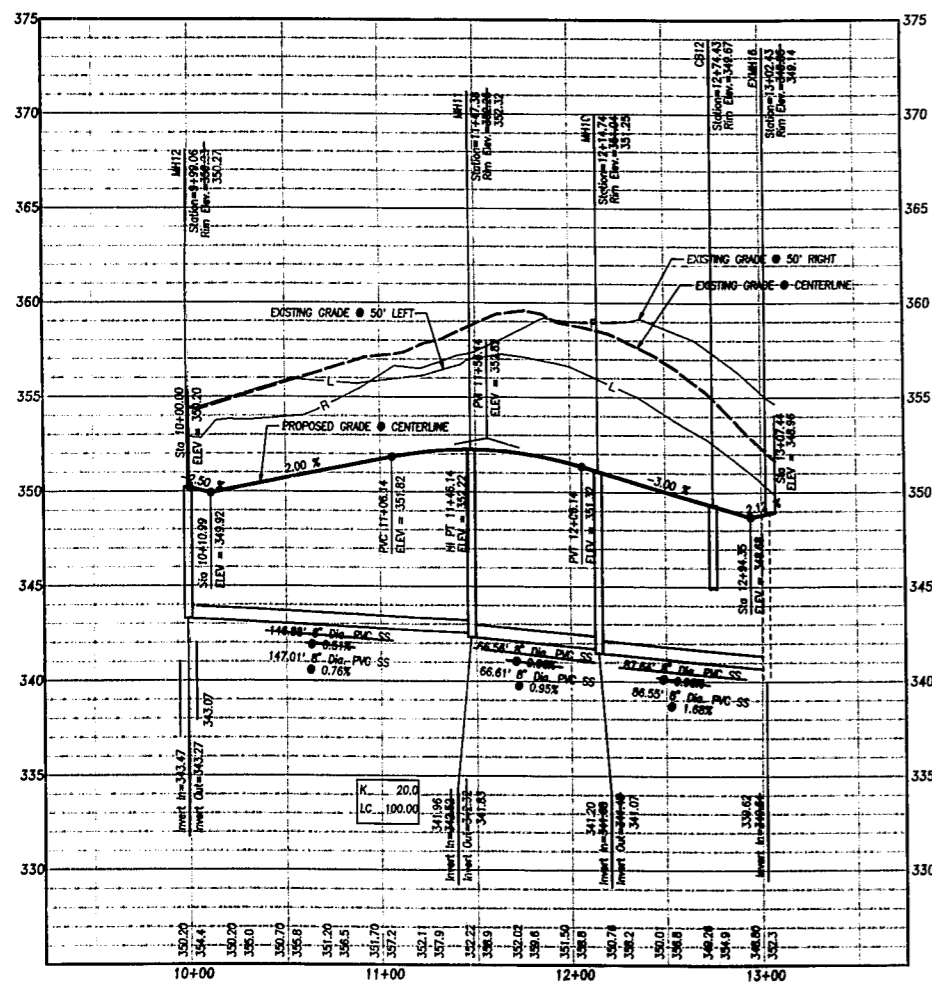

**APPROVED
TOWN OF CARY**

DRC _____ Date _____
 Planning _____ Date _____
 Engineering _____ Date _____

As-Built
 Robert E. Oldham
 4/10/02

PROFESSIONAL SEAL
 2812
 ENGINEER
 ROBERT E. OLDHAM

GRAPHIC SCALE 1"=50'

0 50 100 150

WITHERS & RAVENEL Engineering & Surveying, Inc.
 111 MacKanan Drive - Cary, N.C. 27511
 919-469-3340 FAX 919-467-6008

Revisions			
No.	Description	Date	By

CARY PARK PARCEL SF-11c PHASE 1 AS-BUILT

CARY WAKE COUNTY NORTH CAROLINA

A003 (Sta 10+00.00 - 13+07.44) PLAN & PROFILE

Designer: W&R
 Drawn By: JRI
 Checked By: RTO

Scale: 1"=50'
 Date: 03/07/02
 Job No.: 201124

CAD File: A:\Projects\111111\A003.dwg
 Sheet No.: 7 of 10

K:\01\01-12\01\11A\cary\A003.dwg Fri Mar 8, 2002 8:57:37AM WITHERS & RAVENEL ENGINEERING & SURVEYING