
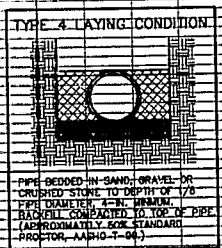
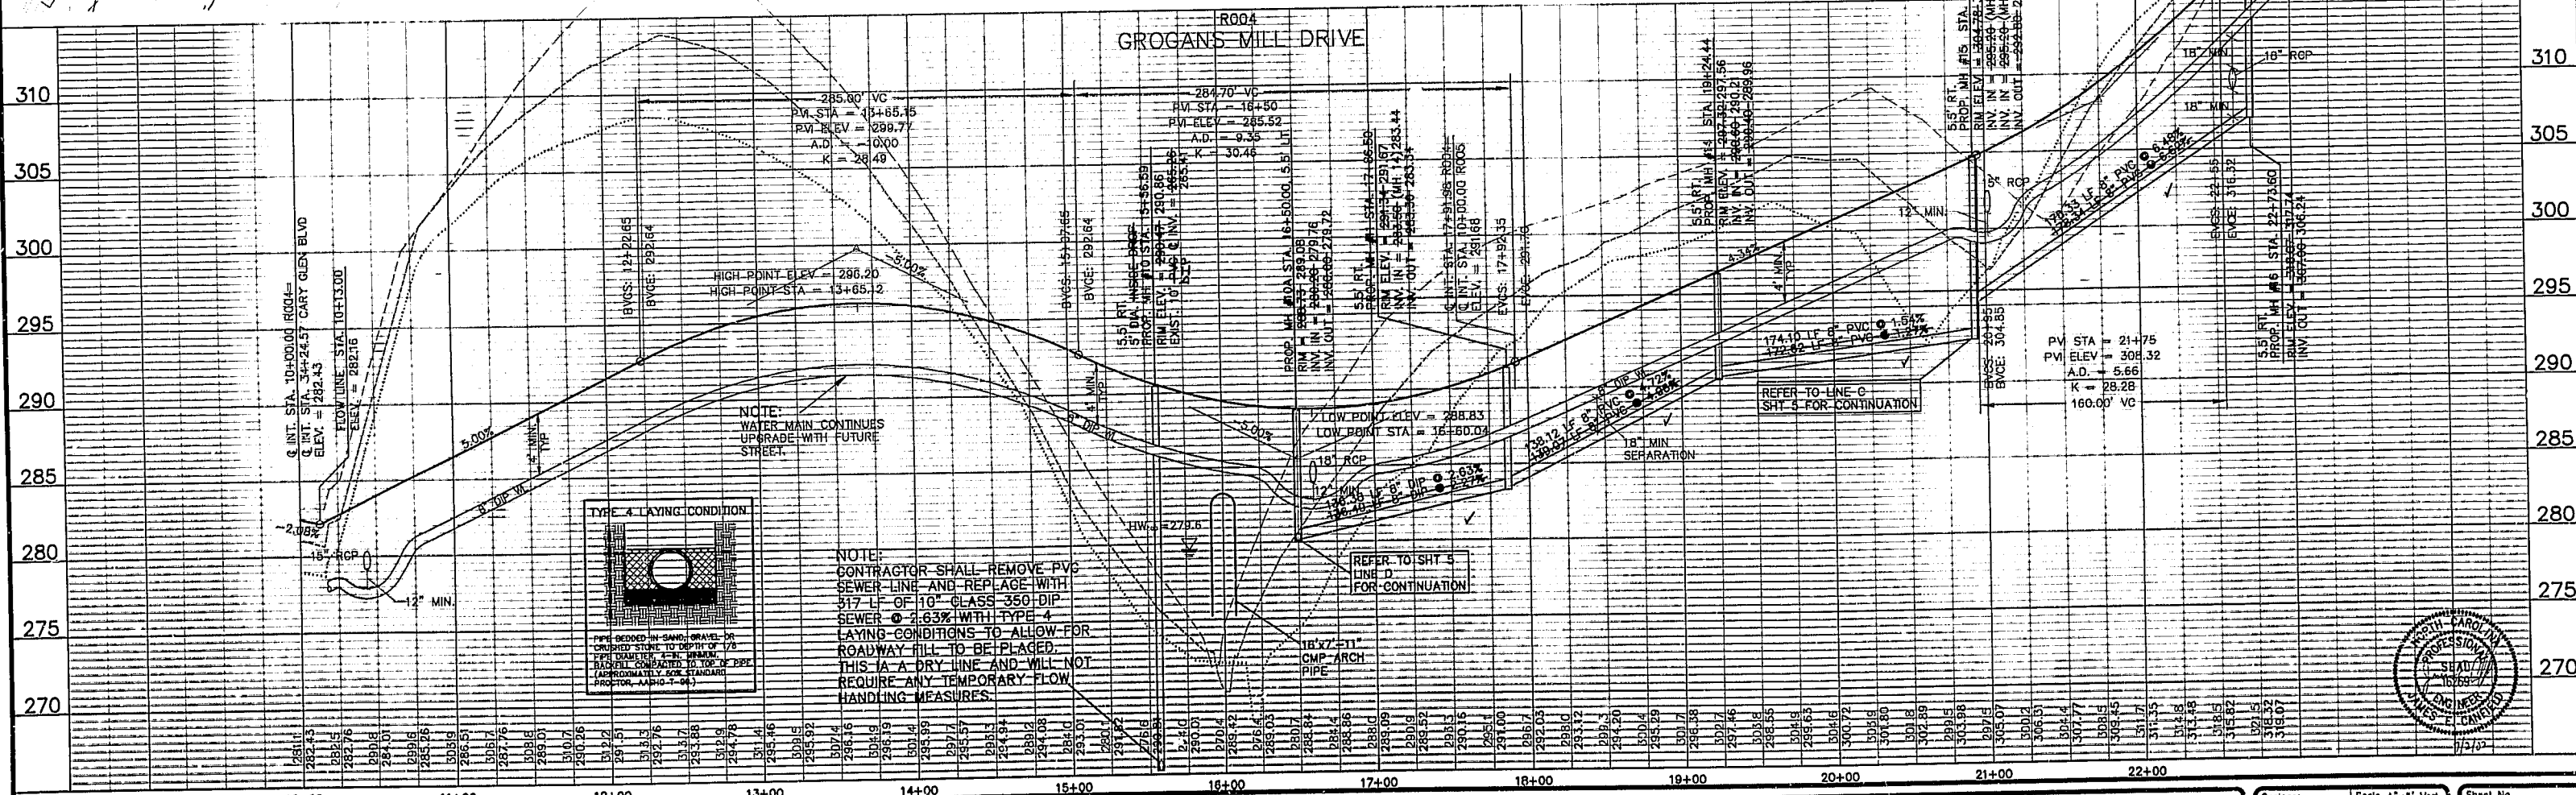


PARCEL SF-9

CARY GLEN BLVD EXTENSION  
REFER TO PLANS BY WITHERS & RAVENEL

GROGANS MILL DRIVE

CURVE TABLE						
CURVE	LENGTH	RADIUS	TANGENT	CHORD	BEARING	DELTA
C1	350.98	375.00	189.54	338.31	S27°16'18"E	53°37'36"
C4	406.74	425.00	220.46	391.39	S28°40'04"E	54°50'02"

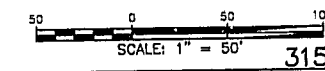

**WITHERS & RAVENEL Engineering & Surveying, Inc.**  
280 111 Mackenan Drive Cary, N.C. 27511  
919-469-3340 FAX 919-467-6008

Revisions			
No.	Description	Date	By

**CARY PARK PARCEL SF-8a**  
CARY PARK P.U.D.

**RO04 PLAN & PROFILE -- AS-BUILT**

Designer WJR	Scale 1"=5' Vert. 1"=50' Horiz.	Sheet No. <b>3</b>
Drawn By JBJ	Date 6/14/02	of
Checked By JEC	Job No. 201135	