
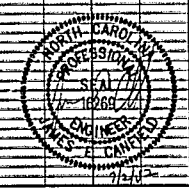


CURVE TABLE						
CURVE	LENGTH	RADIUS	TANGENT	CHORD	BEARING	DELTA
C3	367.13	732.20	187.51	363.30	N24°40'06\"/>	

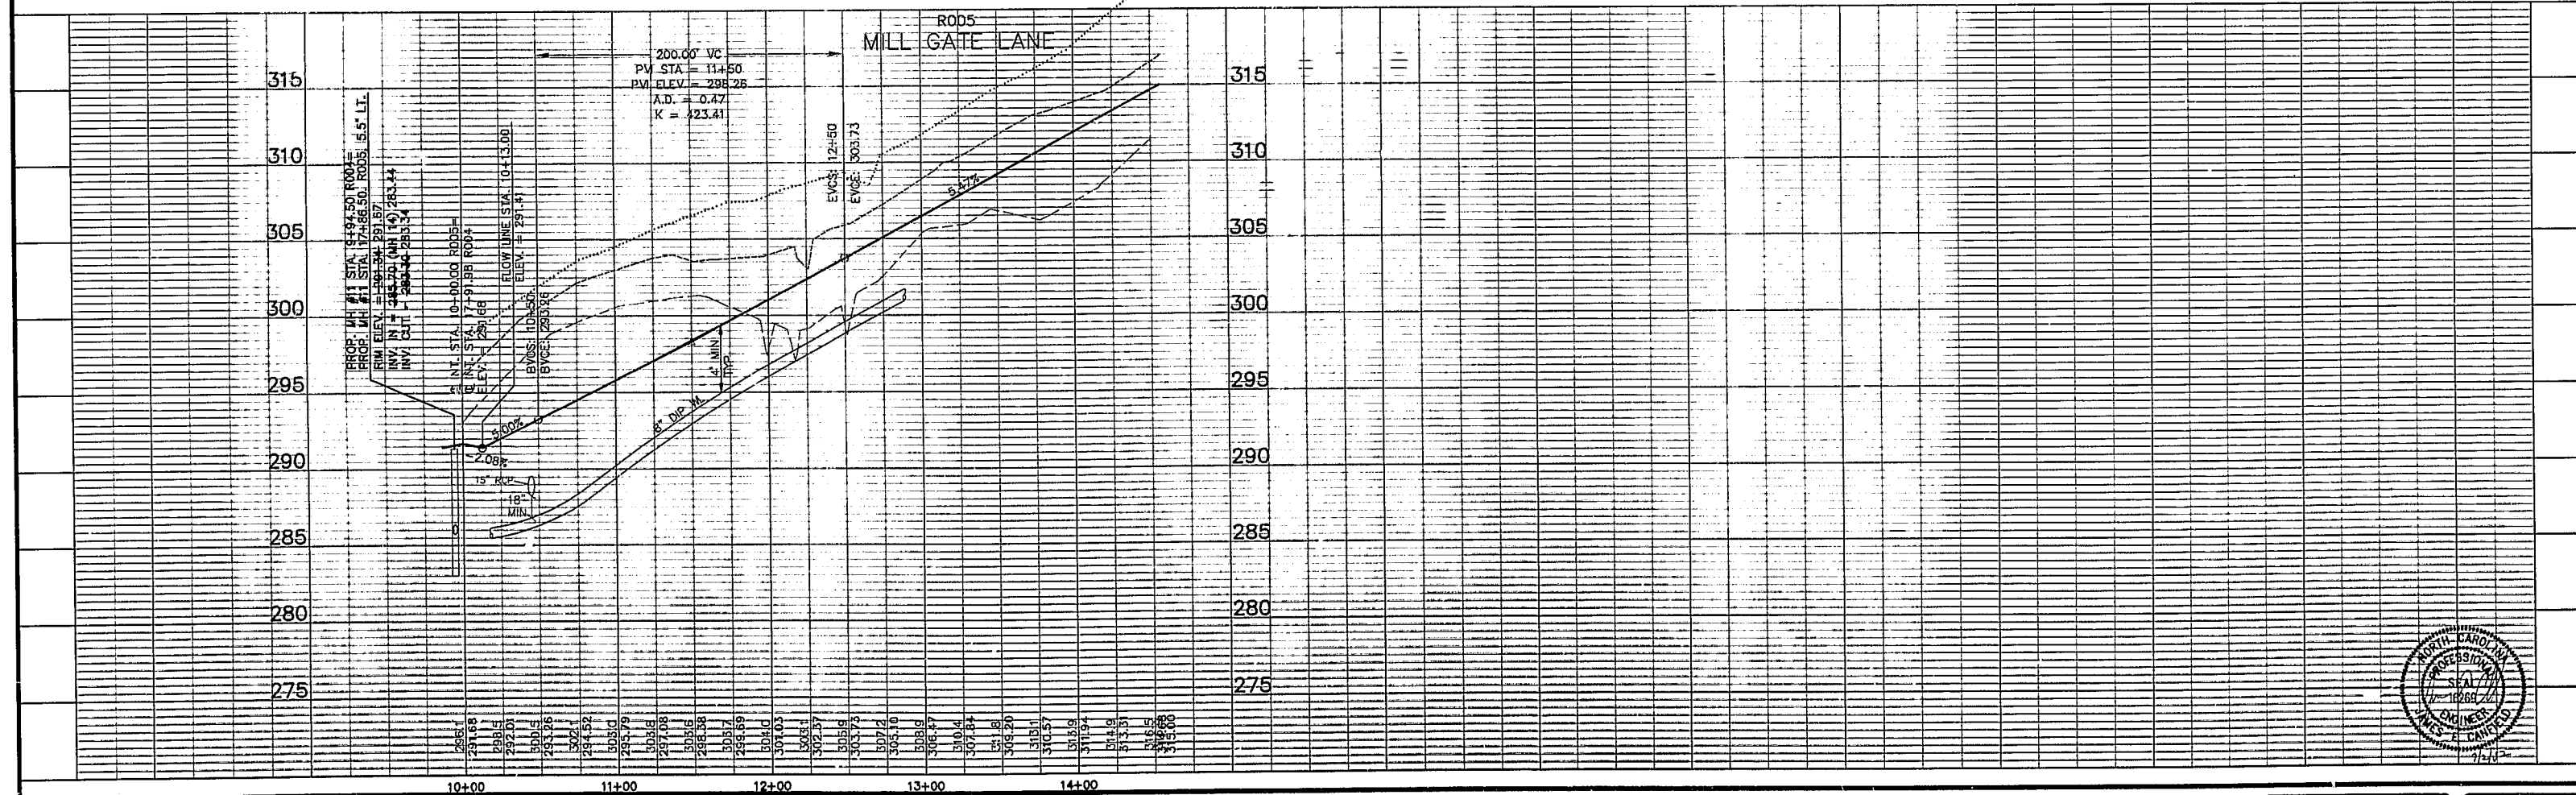

WITHERS & RAVENEL Engineering & Surveying, Inc.
 280 111 MacKenan Drive Cary, N.C. 27511
 919-469-3340 FAX 919-467-6008

Revisions			
No.	Description	Date	By

CARY PARK PARCEL SF-8a
 CARY PARK P.U.D.

R005 PLAN & PROFILE -- AS-BUILT

Designer: W&R
 Drawn By: JFC
 Checked By: JFC
 Scale: 1"=5' Vert., 1"=50' Horiz.
 Date: 6/14/02
 Job No: 201135

Sheet No: **4**
 of 4