

ELAM, TODD, d'AMBROSI
URBAN PLANNING & LANDSCAPE ARCHITECTURE
CIVIL ENGINEERING & LAND USE CONSULTING
2880 SLATER RD, SUITE 200
MORRISVILLE, NORTH CAROLINA 27560

OFFICE 919.481.2021
FAX 919.481.2773
EMAIL etd@etdpa.com



LEVEY KILDAIRE

FINISHING PLAN


CLIENT:
LRC DEVELOPMENT COMPANY, LLC
1585 FREDRICK BLVD
AKRON, OH 44320
330-253-6958

SURVEYOR:
ELINGBURG LAND SURVEY CO., INC
624 W CHATHAM ST
APEX, NC 27639
919-303-6371

WALGREENS
STORE# 10541

Drawn By: BMH
Checked By: BN
Date: 2-10-08
Proj#: 2511009

Revisions
REV 3/21/08 CARY REVIEW COMMENTS
REV 5/12/08 CARY REVIEW COMMENTS
REV 6/25/08 CARY REVIEW COMMENTS
REV 7/11/08 CARY & WALGREENS REV

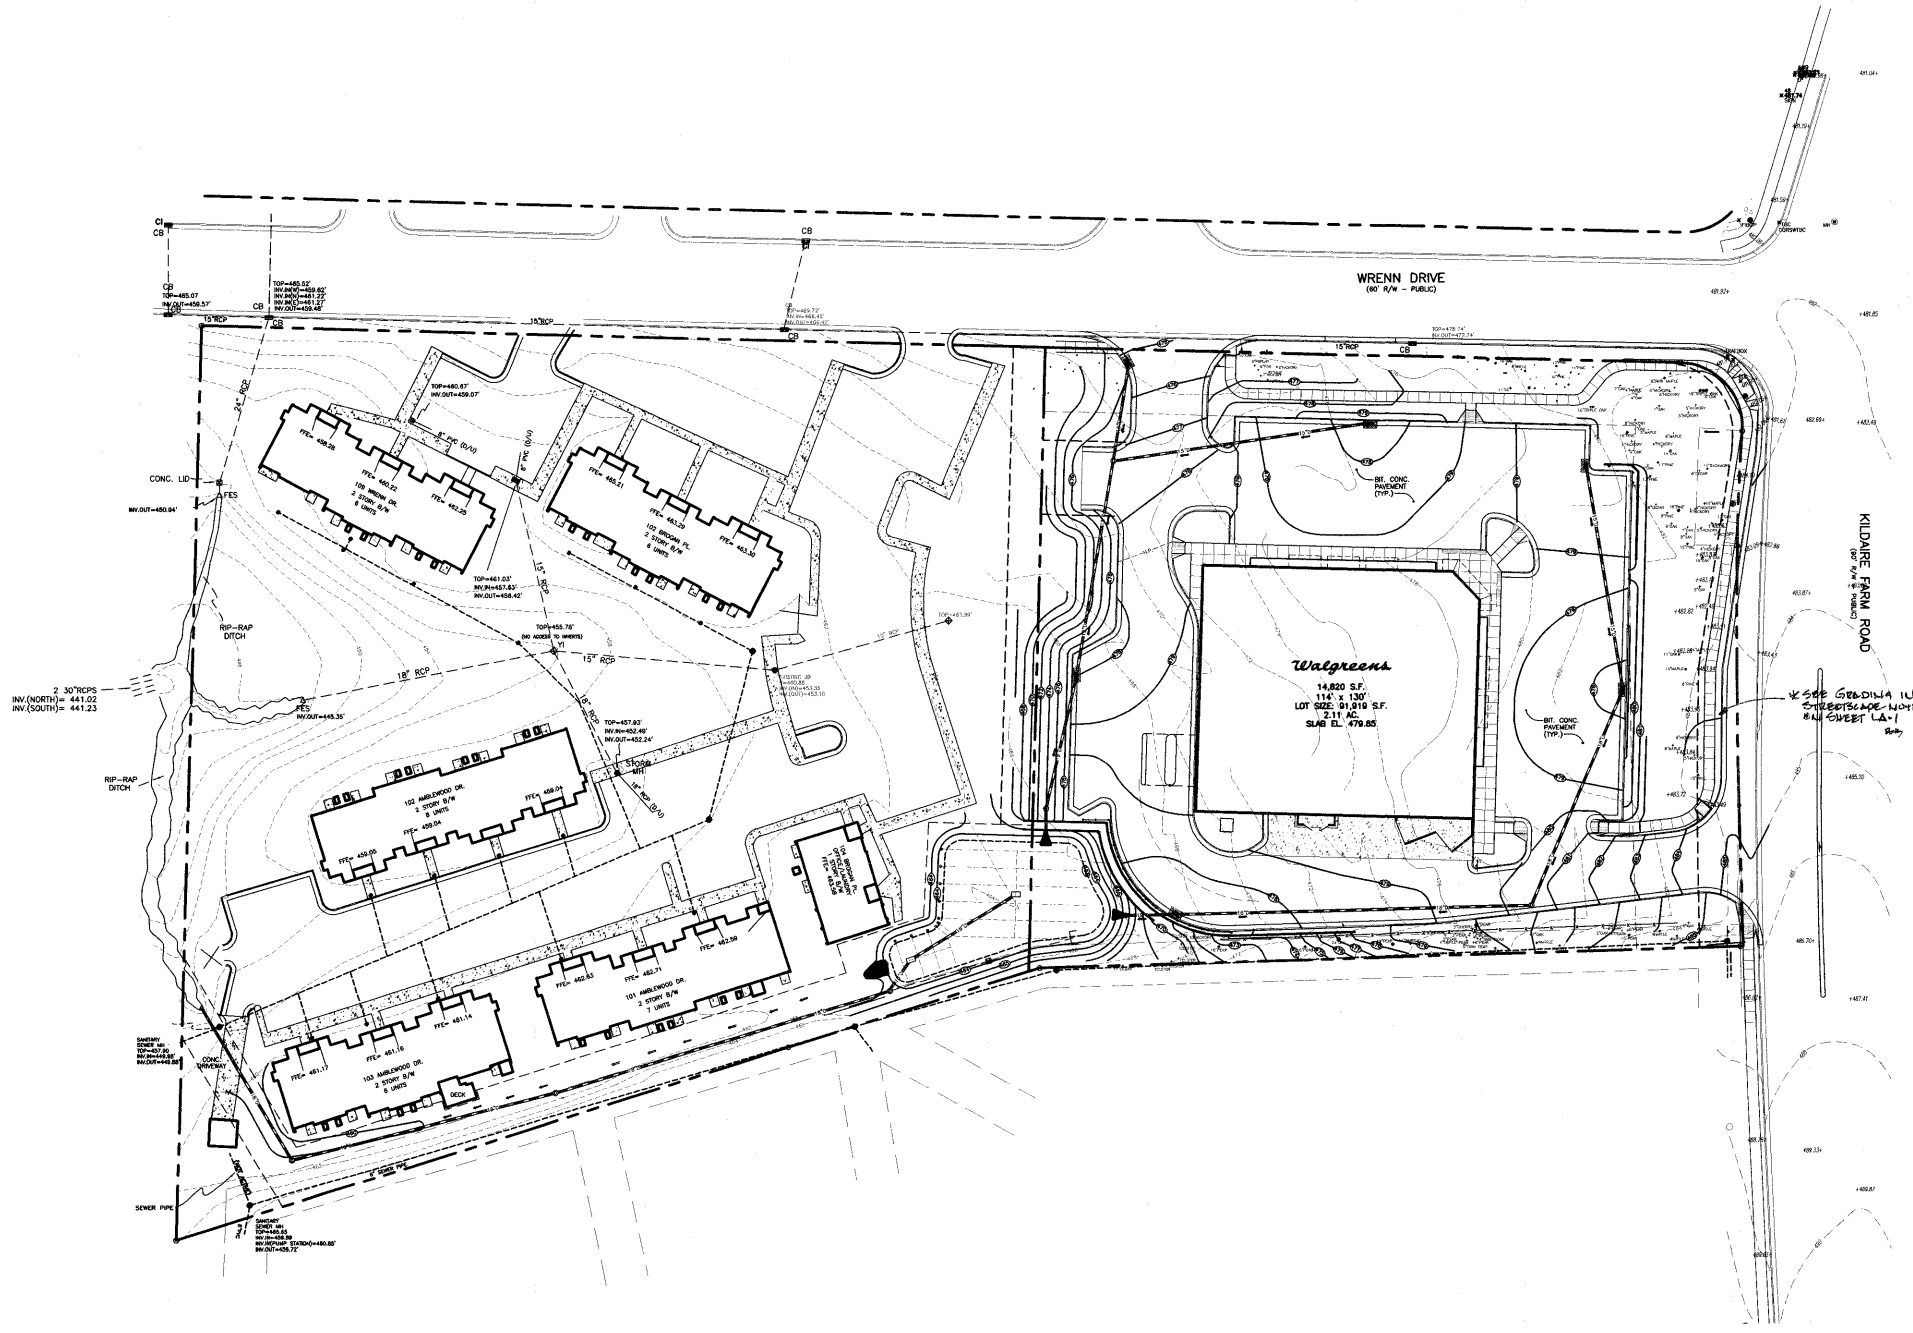

06-SP-012 -A
APPROVED
TOWN OF CARY
Approved by: [Signature] Date: 2-11-08
Planning: [Signature] Date: 2-11-08
Engineering: [Signature] Date: 3-12-08

