



LEVY KILDAIRE

FINISHING PLAN


CLIENT:
 LRC DEVELOPMENT COMPANY, LLC
 1685 FREDRICK BLVD
 AKRON, OH 44320
 330-253-6938

SURVEYOR:
 HILLSBURG LAND SURVEY CO., INC
 624 W CHATHAM ST
 APEX, NC 27509
 919-363-5371

WALGREENS STORE# 10541

Drawn By: SMH
 Checked By: BN
 Date: 8-10-06
 Proj#: 2241009

Revisions
 REV 3/24/06 CARY REVIEW COMMENTS
 REV 6/12/06 CARY REVIEW COMMENTS
 REV 6/29/06 CARY REVIEW COMMENTS
 REV 7/11/06 CARY & WALGREENS REV

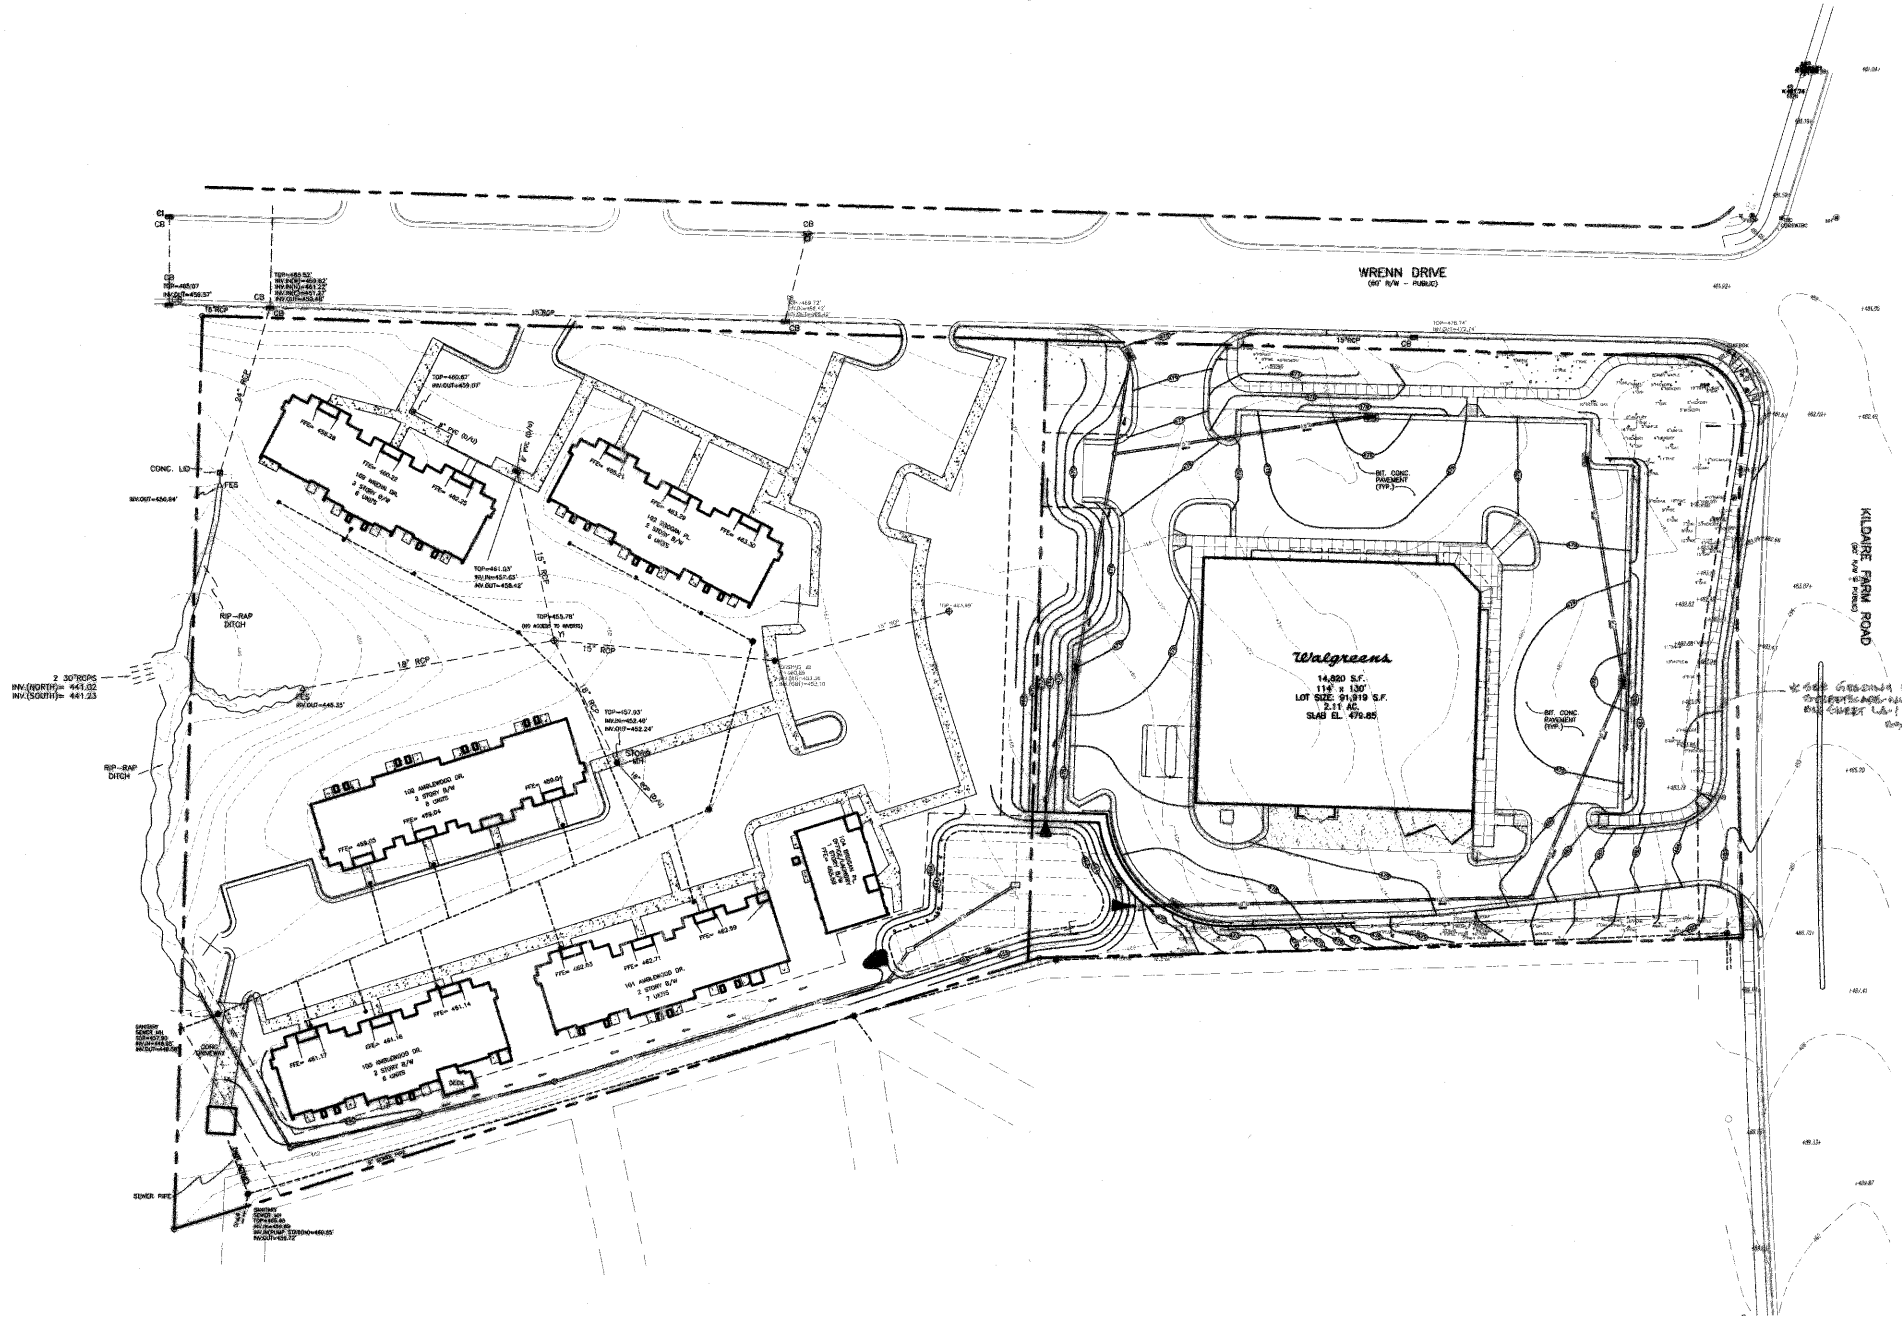

06-SP-012
APPROVED
TOWN OF CARY
 Approved by: [Signature] Date: 8/10/06
 Planning: [Signature] Date: 8/10/06
 Engineering: [Signature] Date: 8/12/06

