
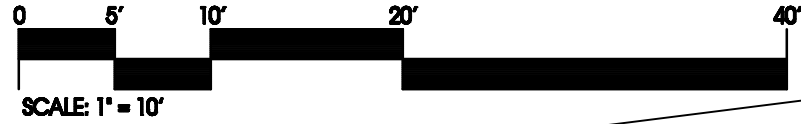


NOTE: AS-BUILT SURVEY DATA OF RETAINING WALL MK1 AND WALL 67 COLLECTED ON JUNE 27, 2019 BY WITHERSRAVENEL, INC.

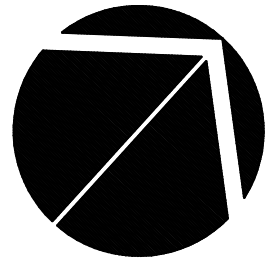

EXISTING STORM DRAINAGE

LAMPWICK LANE
PRIVATE R/W

TW: 411.85
BW: 411.58

TW: 413.83
BW: 411.50

NEW SEGMENTAL BLOCK
RETAINING WALL (LOCATION
AS-BUILT) WALL # 67

PROPOSED 6'
RETAINING WALL
MAINTENANCE
EASEMENT

LOT 8
729 LAMPWICK LANE

LOT 7
727 LAMPWICK LANE

LOT 6
723 LAMPWICK LANE

LOT 5
721 LAMPWICK LANE

EXISTING 18'
PRIVATE STORM
DRAINAGE
EASEMENT

TW: 413.83
BW: 411.92

TW: 412.52
BW: 411.92

APPROVED by the Town of Cary
Development Review Committee



19-DP-10441

By: Kevin A. Hales
07/30/2019

K:\15-0030\150037.10-Chapel Hill Road Townes\CAD\Plan.pro Tue Jul 23, 2019 11:45:05AM WITHERS & RAVENEL, ENGINEERS, PLANNERS & SURVEYORS

No.	Revision	Date	By	Designer	Scale
1	Town Comments	7/23/19	RSF	WR	1" = 10'
				Drawn By	Date
				RSF	7/3/2019
				Checked By	Job No.
				RSF	2150037.10

PARK WEST TOWNES RETAINING WALLS
TOWN OF CARY WAKE COUNTY NORTH CAROLINA

MINOR ALTERATION PLAN
RETAINING WALL 67

WithersRavenel
Engineers | Planners
137 S. Wilmington Street | Suite 200 | Raleigh, NC 27601
t: 919.469.3340 | license #: C-0832 | www.withersravenel.com