R:/96385000/RCP01010.DGN

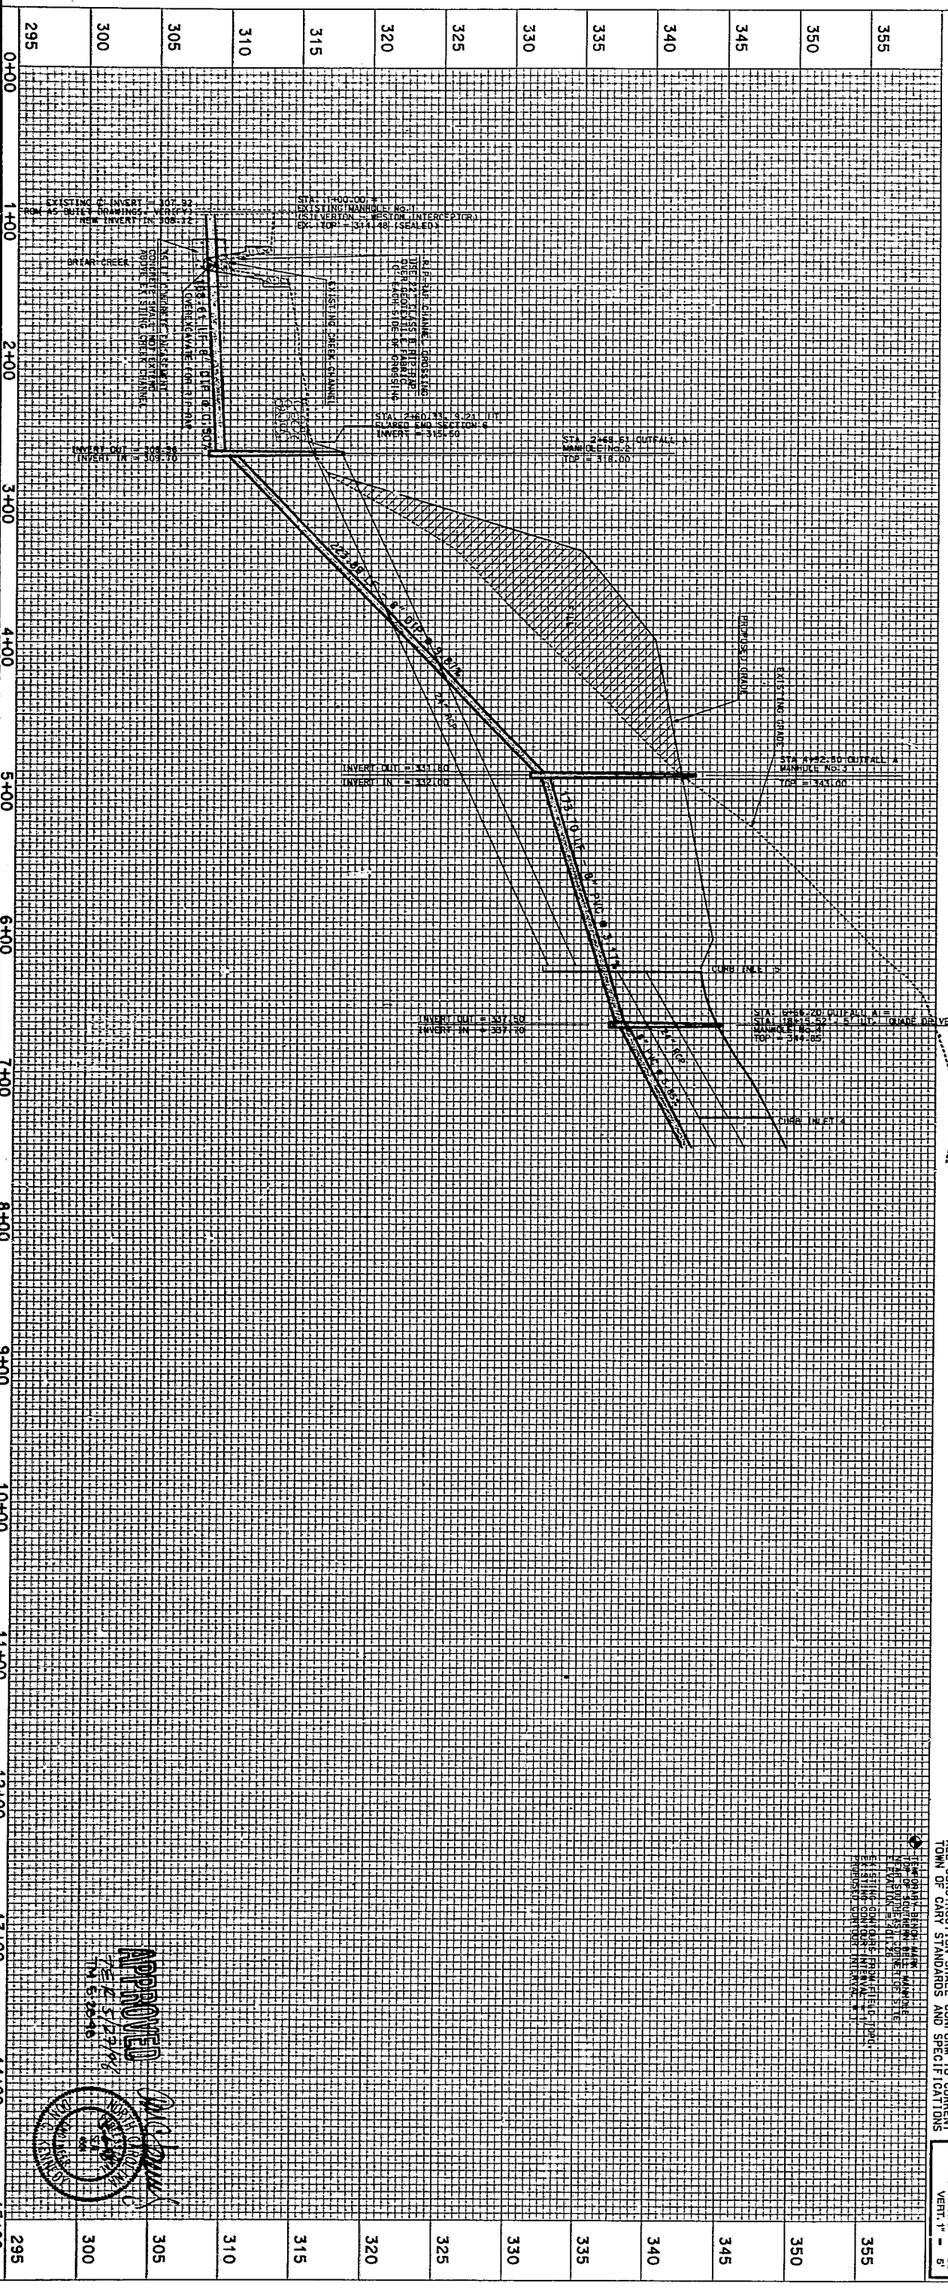

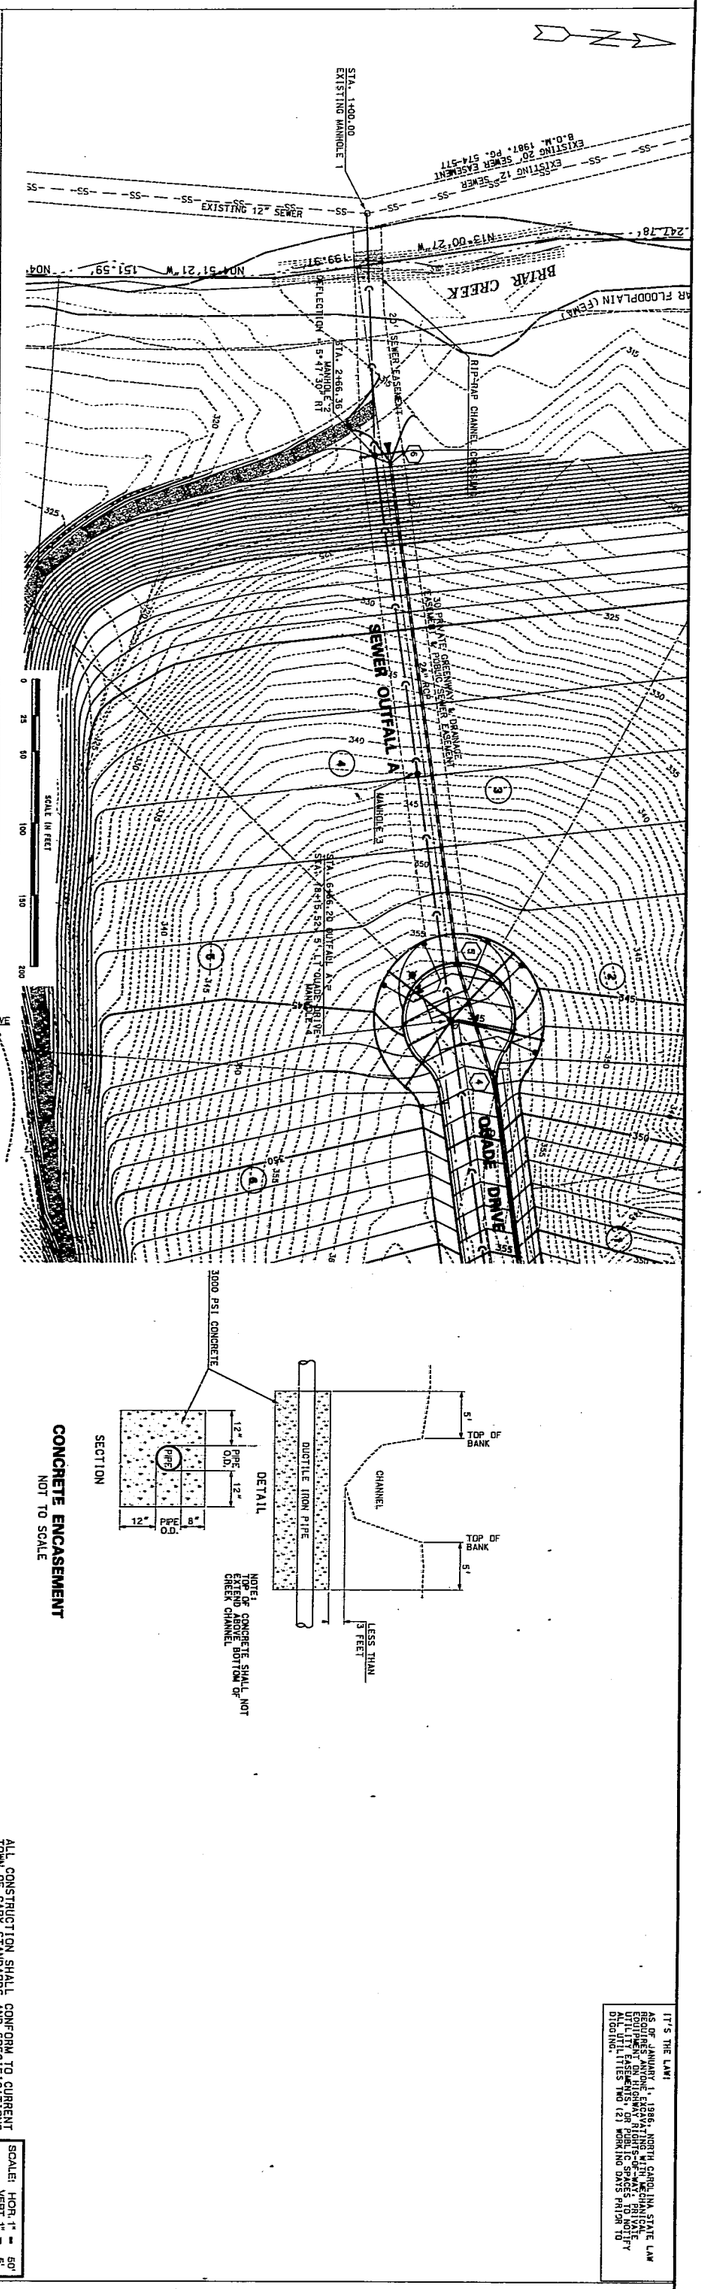

ALL CONSTRUCTION SHALL CONFORM TO CURRENT TOWN OF CARY STANDARDS AND SPECIFICATIONS

SCALE: HOR. 1" = 50'
VERT. 1" = 5'

IT'S THE LAW!
AS OF JANUARY 1, 1986, NORTH CAROLINA STATE LAW REQUIRES CONTRACTORS TO NOTIFY ALL UTILITIES OF EXCAVATION OR DEMOLITION EQUIPMENT ON HIGHWAY RIGHTS-OF-WAY OR PRIVATE EASEMENTS OR PUBLIC SPACES TO NOTIFY UTILITIES TWO (2) WORKING DAYS PRIOR TO DIGGING.

APPROVED
AS-BUILT
DATE 5/29/98
TOWN OF CARY, NORTH CAROLINA

SHEET	CENTREWEST SOUTH	96385000 AUGUST 1997 BGB					
C4.2	CARY, WAKE COUNTY, NORTH CAROLINA	JOB NO. DATE DRAWN BY	4	4/8/98		
6 OF 7		PLAN & PROFILE	3	0/24/97		
		SCALE: 1" = 50' H. 1" = 5' V	2	9/18/97		
			1	8/25/97	5	5/4/98
			NO.	DATE	NO.	DATE
			REVISIONS			

BASS, NIXON, & KENNEDY, INC., CONSULTING ENGINEERS
919-851-4422 7416 CHAPEL HILL ROAD, RALEIGH, N. C. 27607

BNK

QUIT ALL "Y"

NOT PERMITTED FOR CONSTRUCTION