NOTE:
1- CONTRACTOR TO PLACE BACKFILL AROUND PUMP STATION AT 95% STD. PROCTOR. ASTM D-698.
2- ALL ELECTRICAL MOTORS & OTHER ELECTRICAL COMPONENTS LOCATED IN DRY PIT TO BE SUITABLE FOR OPERATION IN CLASS I, DIVISION II, GROUP G ATMOSPHERES (EXPLOSION PROOF)

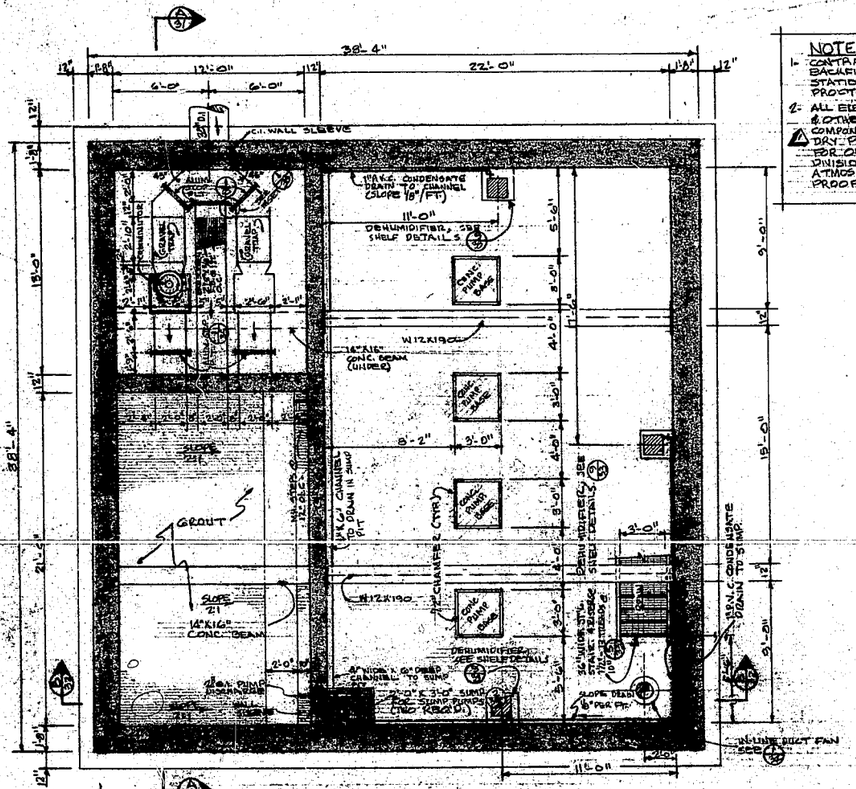

LOWER LEVEL FLOOR PLAN
SCALE: 1/4"=1'-0"

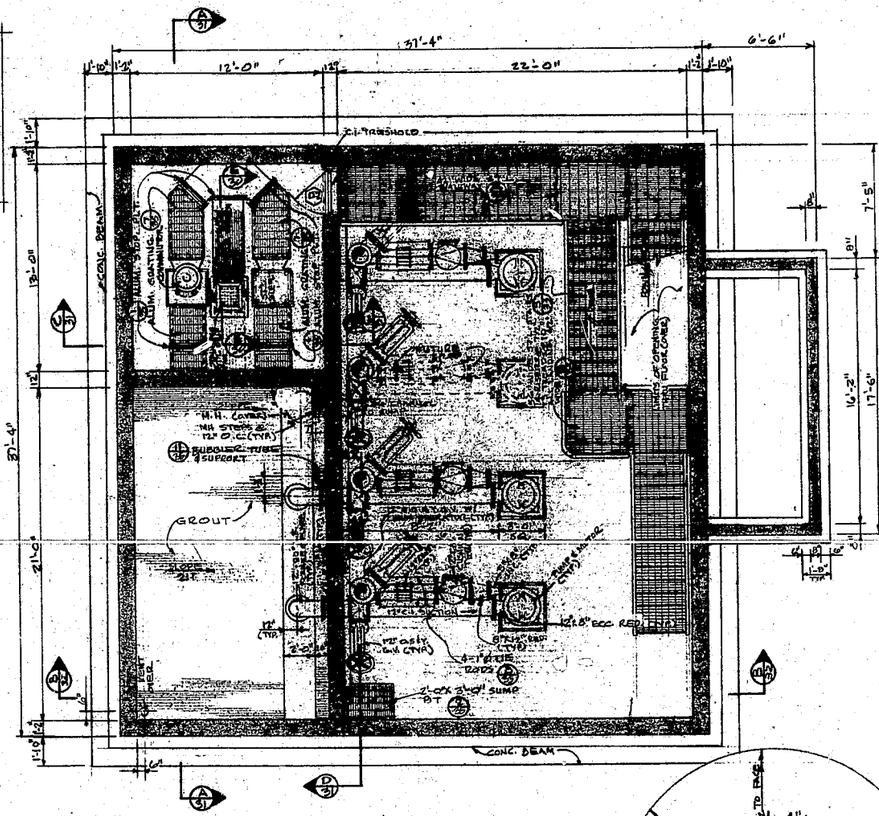

INTERMEDIATE LEVEL PLAN
SCALE: 1/4"=1'-0"

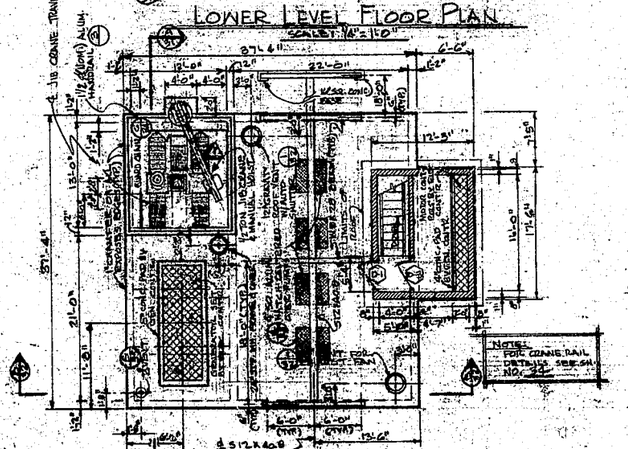

UPPER LEVEL PLAN
SCALE: 1/4"=1'-0"

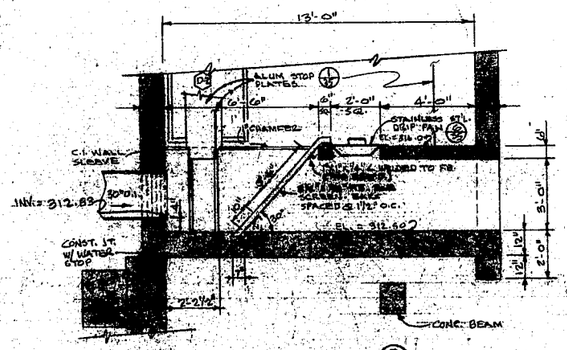

SECTION E/50
SCALE: 1/2"=1'-0"

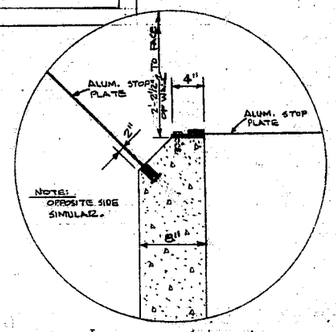

INSET NO. 1
SCALE: 1/2"=1'-0"

ENGINEER: William F. Maxwell	DATE: 4/73	DATE: 10/73	SWIFT CREEK PUMPING STA. PLAN & DETAILS
DATE: 5/8/73			WASTEWATER IMPROVEMENTS
SEAL			TOWN OF CARY
			WAKE COUNTY, NORTH CAROLINA
			MOORE, GARDNER & ASSOCIATES, INC. CONSULTING ENGINEERS ASHEBORO • GREENSBORO • CARY, NORTH CAROLINA
SCALE: NOTED	JOB NO. 207173	SHEET 50 OF 44	
	DRAWER NO. 18		

DRAWN BY: Shane
CHECKED BY: WFM
APP'D. BY: WFM

REVISED TO CONFORM TO AS-BUILT CONDITIONS 4-1-00

MARK | DATE | REVISION | APP'D.

SOUTHERN PHOTO-PRINT & SUPPLY CO., GREENSBORO, N.C.